


- NOTES CONTINUED
11. AREAS OF EXISTING GRASS VEGETATION DISTURBED DURING THE WORKS SHALL BE REINSTATED WITH MINIMUM 150mm TOPSOIL AND MIXTURE 2 GRASS SEED IN ACCORDANCE WITH TABLE 1 ON DRAWING I-363005-07-10. SURFACES OF SOWN GRASS SEED SHALL BE REDUCED TO A FINE TILTH AND CLEARED OF STONES AND EXTRANEIOUS MATERIAL GREATER THEN 50mm IN SIZE. THE SEED SHALL BE SOWN IN THE PROPER SEASON, EVENLY DISTRIBUTED AND APPLIED AT A RATE NOT LESS THAN 35g/m².

12. ROOT PROTECTION AREAS ARE BASED ON TREE CONSTRAINTS PLAN PROVIDED BY AECOM LIMITED. REFERENCE 0571450-ACM-XX-XX-AB-TCP-001, REVISION P1, DATED 21.03.22. ROOT PROTECTION AREAS OF TREES TO BE RETAINED TO BE PROTECTED FROM DAMAGE.


13. FLOOD ALLEVIATION SCHEME (FAS) DESIGNED BY OTHERS. REFER TO NEATH PORT TALBOT COUNTY BOROUGH COUNCIL (NPTCBC) INFORMATION.

14. LOCATION AND LEVEL OF CONNECTION POINTS TO BE CONFIRMED ON SITE BY THE Contractor IN ADVANCE OF WORKS COMMENCING. ANY DISCREPANCIES SHALL BE REPORTED TO THE DESIGNER IMMEDIATELY.


15. DESIGN IN ABEYANCE. PENDING CONFIRMATION OF THE POSITION OF EXISTING UTILITIES. SEE NOTE 8. DESIGN TO BE REVIEWED PRIOR TO CONSTRUCTION, WHEN POSITION OF UTILITIES IS CONFIRMED.

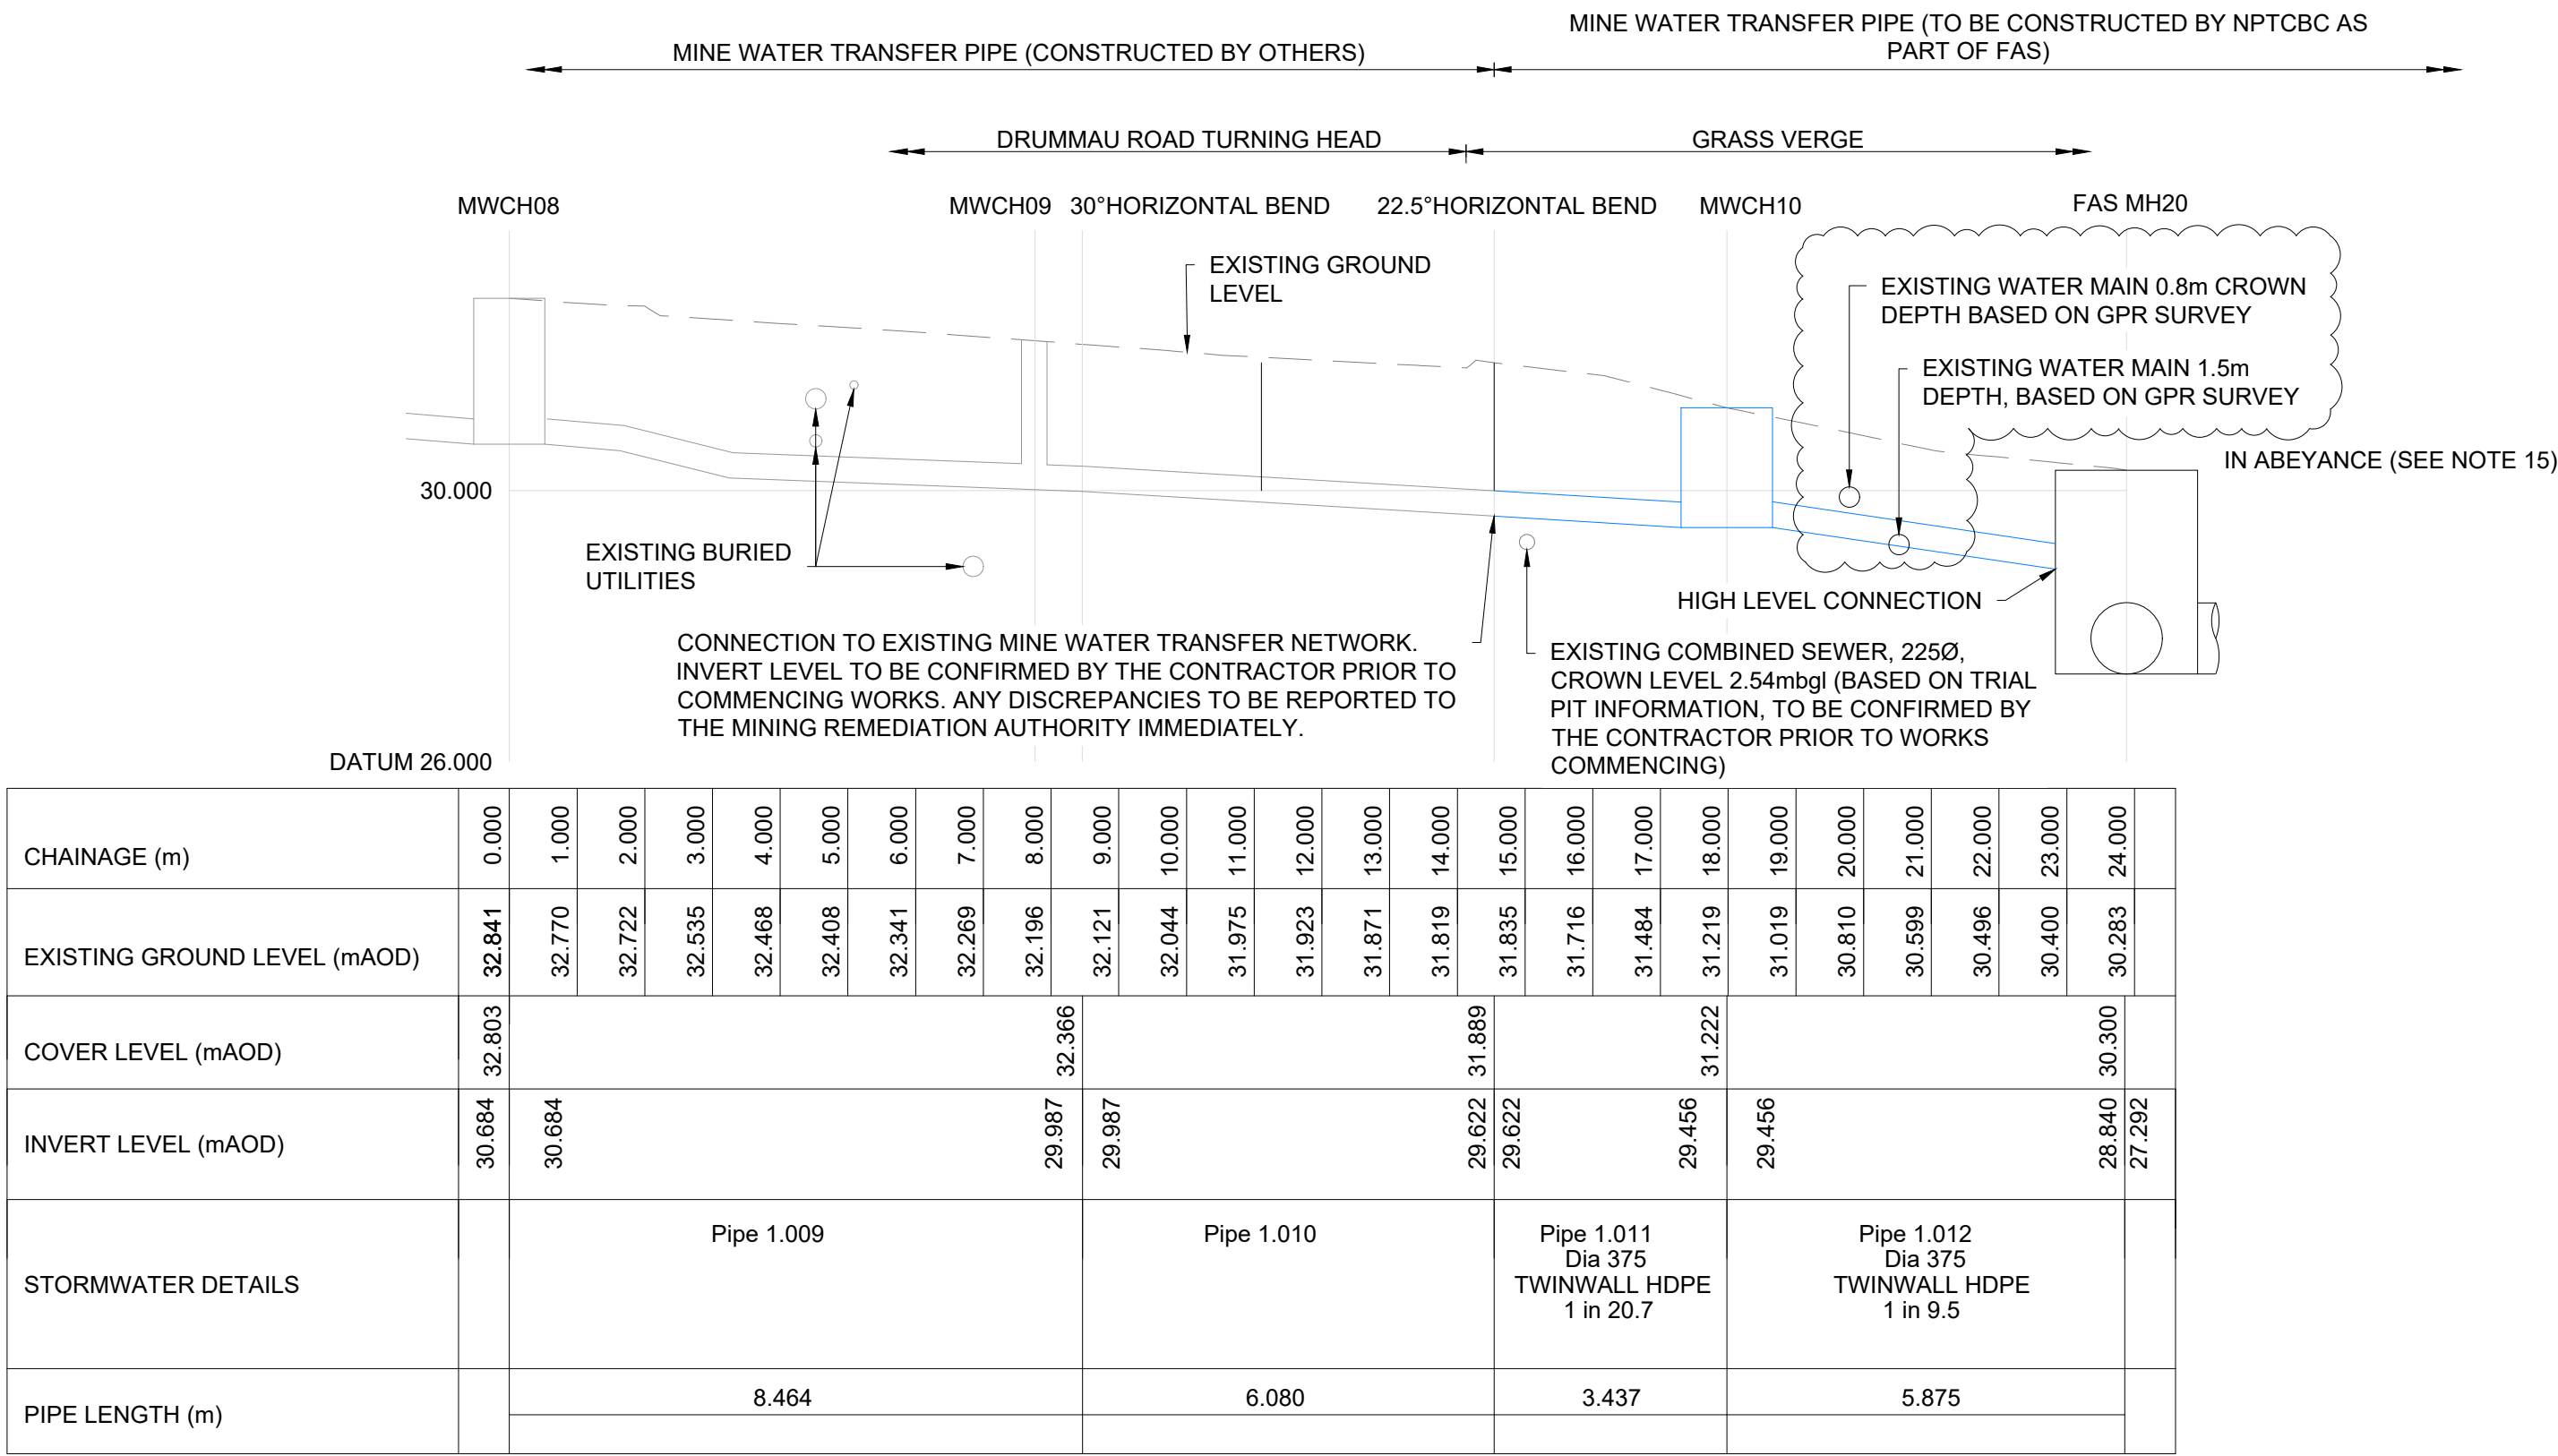

LONGITUDINAL SECTION
(1.009 to 1.012)
1:100

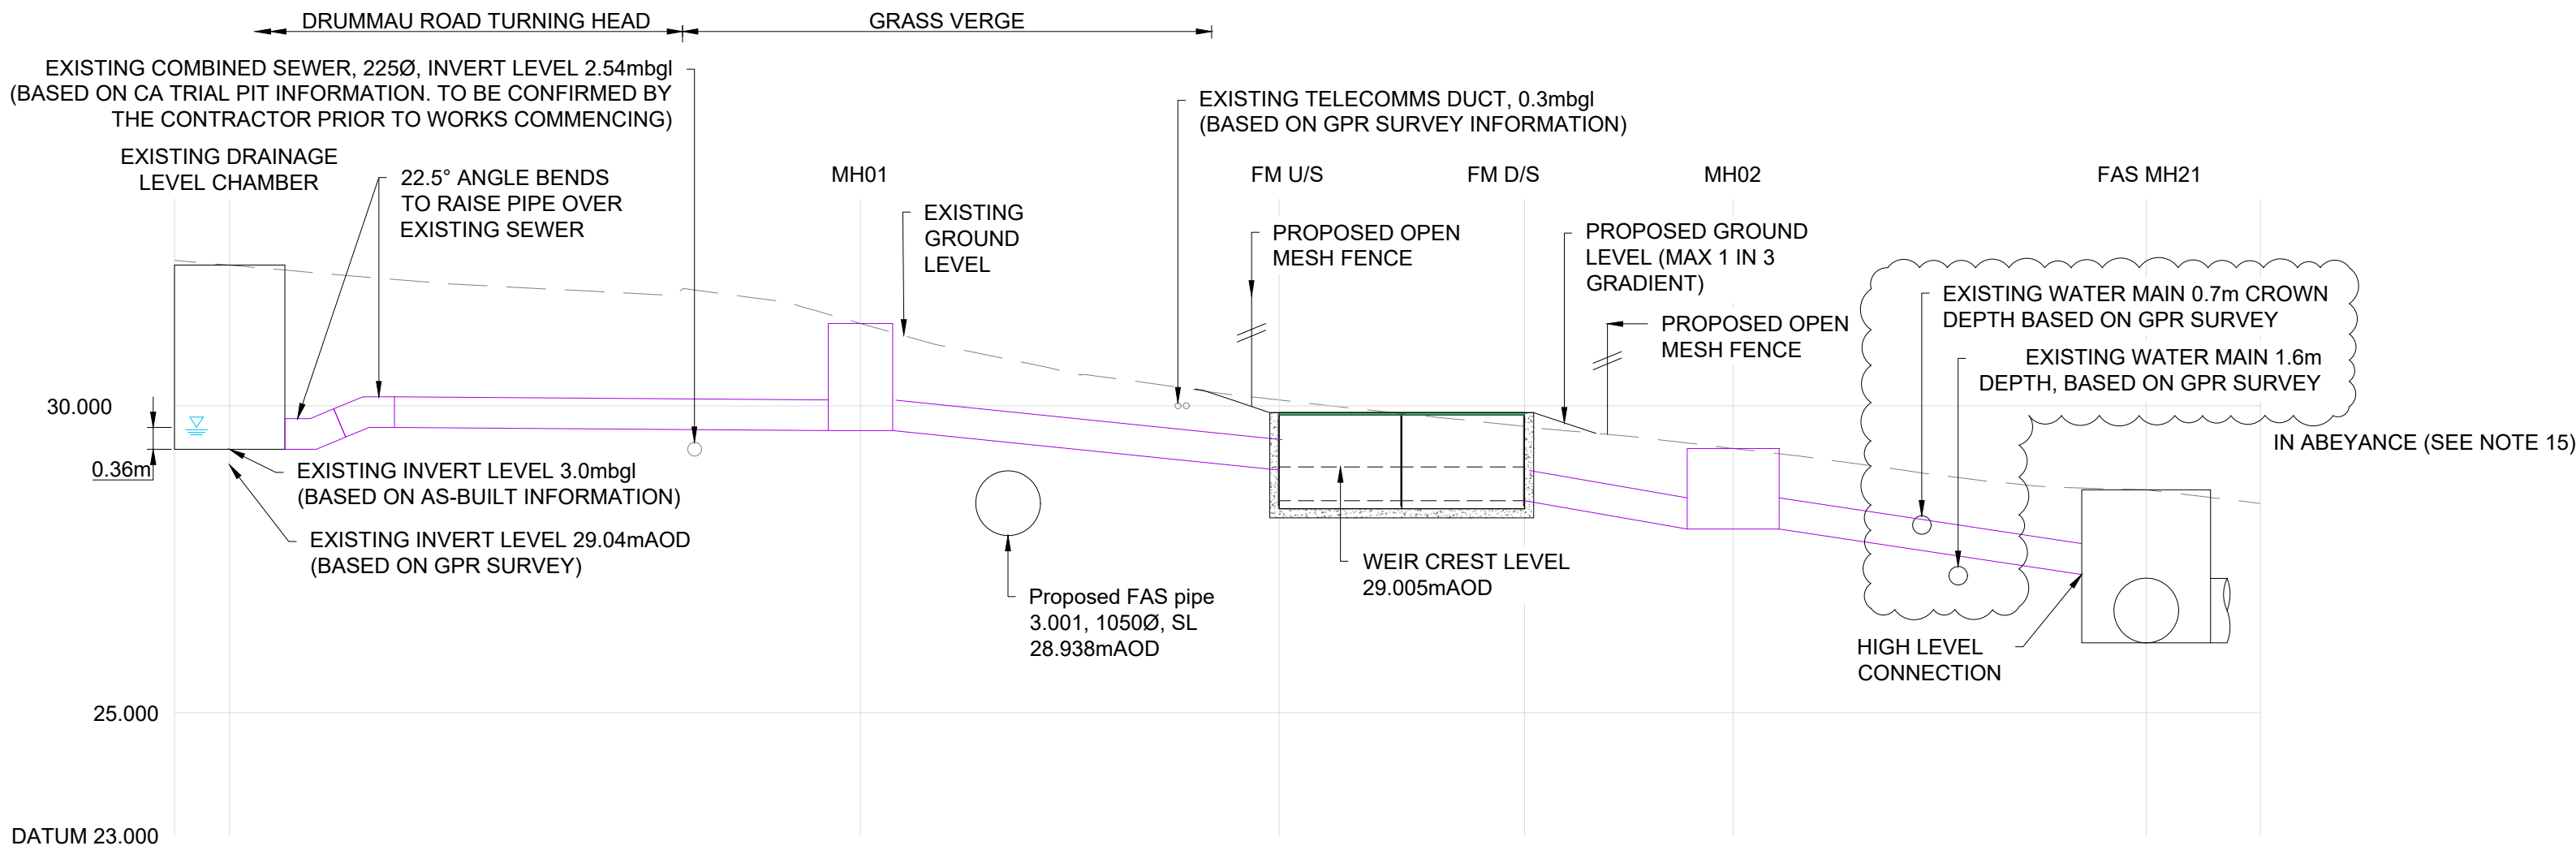

LONGITUDINAL SECTION
(2.000 to 2.003)
1:100

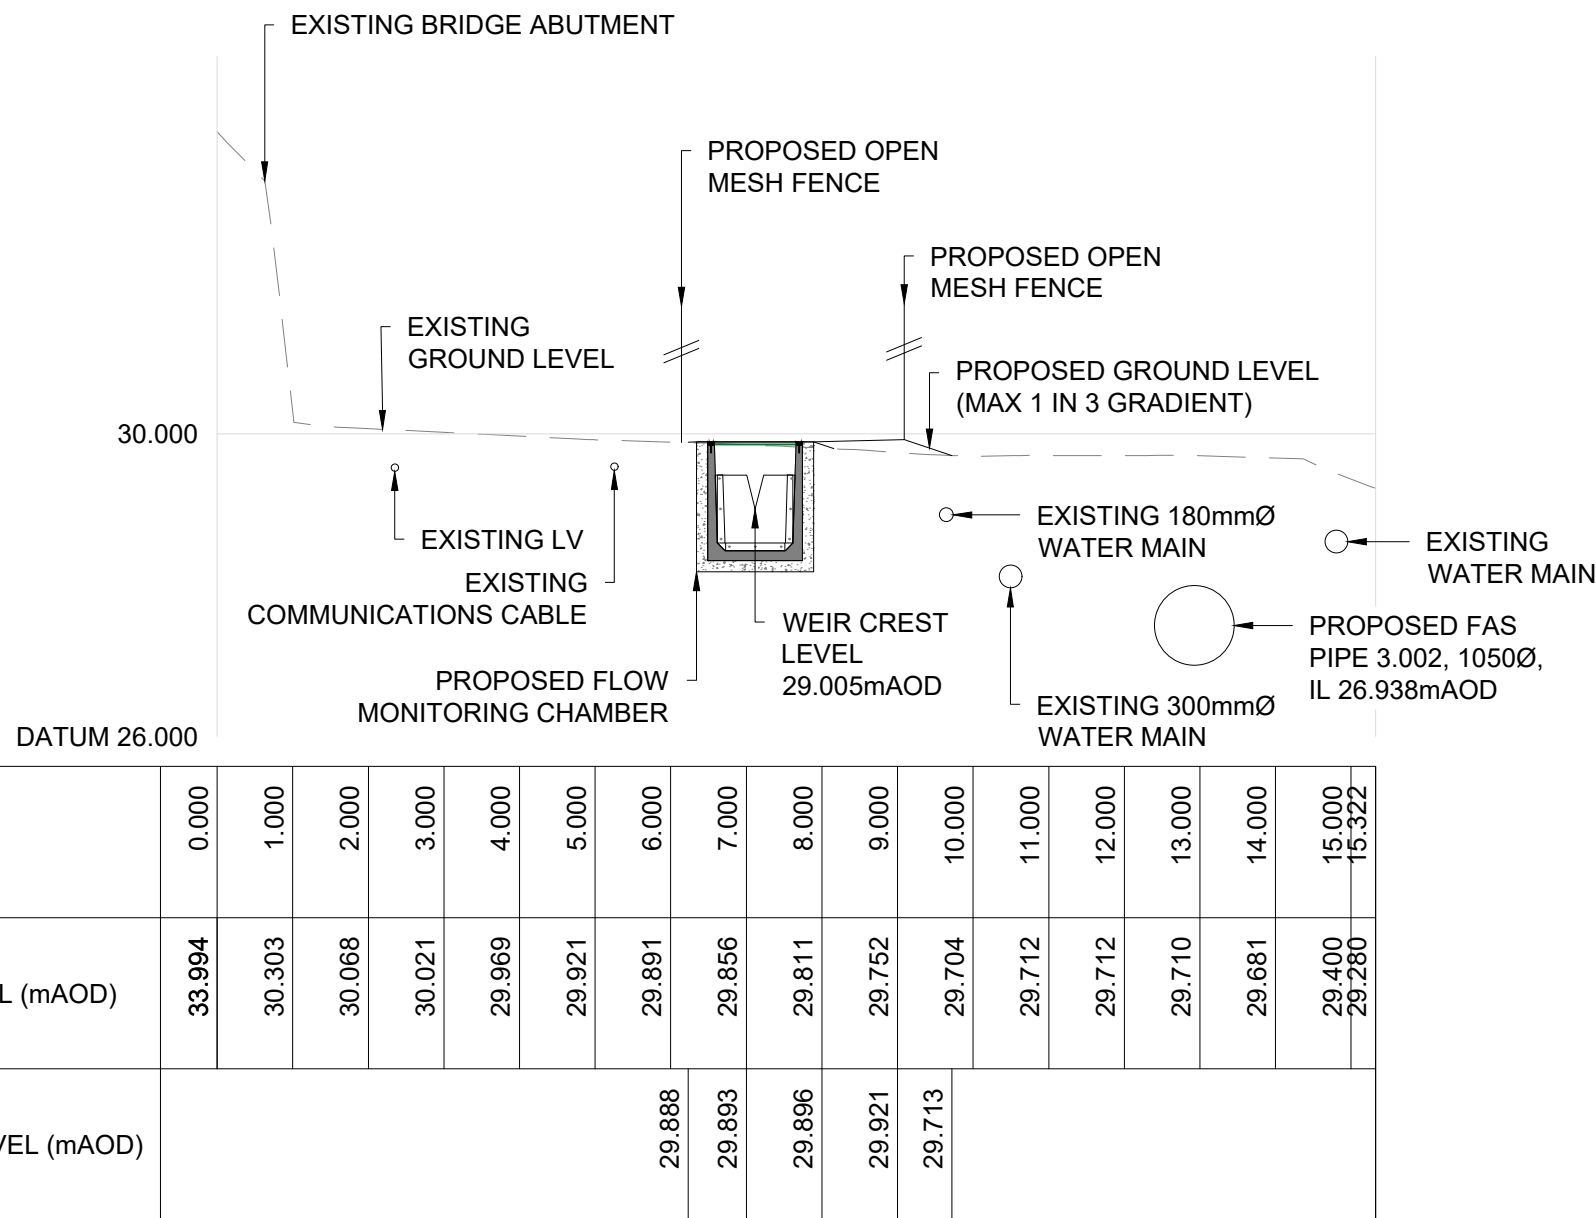

SECTION A-A
1:100

These maps are reproduced from Ordnance Survey material with the permission of Ordnance Survey on behalf of the controller of His Majesty's Stationery Office. © Crown copyright [and database rights][2025][OS AC0000820577]. You are permitted to use this data solely to enable you to respond to, or interact with, the organisation that provided you with the data. You are not permitted to copy, sub-license, distribute or sell any of this data to third parties in any form.

- NOTES
1. DO NOT SCALE THIS DRAWING. ALL DIMENSIONS MUST BE CHECKED/ VERIFIED ON SITE. IF IN DOUBT ASK.

2. THIS DRAWING IS TO BE READ IN CONJUNCTION WITH ALL RELEVANT COAL AUTHORITY DRAWINGS AND SPECIFICATIONS.

3. ALL DIMENSIONS IN MILLIMETRES UNLESS NOTED OTHERWISE. ALL LEVELS IN METRES UNLESS NOTED OTHERWISE.

4. ANY DISCREPANCIES NOTED ON SITE ARE TO BE REPORTED TO THE DESIGNER IMMEDIATELY.

5. FOR DRAINAGE LEVEL FLOW MONITORING COMPOUND LAYOUT, REFER TO DRAWING I-363005-07-10. FOR DRAINAGE LEVEL FLOW MONITORING COMPOUND DETAILS, REFER TO DRAWING I-363005-07-12.

6. ALL WORKS TO BE IN ACCORDANCE WITH THE SPECIFICATION FOR HIGHWAY WORKS (SHW), UNLESS OTHERWISE STATED.

7. DRAWING IS BASED ON TOPOGRAPHICAL SURVEY PROVIDED BY INTERLOCKS SURVEYS LIMITED, DRAWING REFERENCE 210072, DATED 11.02.21 AND AS-BUILT INFORMATION FOR THE MWTP, PROVIDED BY JN BENTLEY, DATED 03.08.23.

8. LAYOUT AND LEVEL OF EXISTING SERVICES IS BASED ON GPR SURVEY INFORMATION PROVIDED BY LANDMARK SURVEYS WALES, REFERENCE 6028_R2, DATED 19.11.21 AND CORNERSTONE PROJECTS LTD UTILITIES SEARCH REPORT, DATED 07.04.21. REFERENCE I-363005. WHERE GPR SURVEY DOES NOT INLCUDE THE LEVEL OF EXISTING PUBLIC UTILITIES, THE LEVEL HAS BEEN BASED ON NJUG PUBLICATION: VOLUME 1 ISSUE 9, RECOMMENDED MINIMUM DEPTHS, TABLE 1. LOCATION AND LEVEL OF EXISTING SERVICES TO BE CONFIRMED ON SITE. BY THE Contractor PRIOR TO WORK COMMENCING. ANY DISCREPANCIES TO BE REPORTED TO THE DESIGNER IMMEDIATELY.

9. DETAILS OF EXISTING DRAINAGE LEVEL CHAMBER ARE BASED ON AS-BUILT CHAMBER DETAIL DRAWING.

10. EXISTING KNOWTWEED IS PRESENT ON SITE IN THE VICINITY OF THE PROPOSED OUTFALL AND EXISTING WATERCOURSE. THE Contractor SHALL TAKE STEPS TO PREVENT SPREAD. ALL EXCAVATION ARISINGS CONTAINING KNOTWEED TO BE REMOVED OFF SITE TO A SUITABLY LICENSED TIP.

P3	03.10.25	COORDINATION WITH UPDATED FAS PROPOSALS	HC	RP	RP
P2	05.10.23	REVISED BASED ON PHASE 2 AS-BUILT INFORMATION AND NPTCBC COMMENTS	HC	CW	-
P1	27.04.23	PRELIMINARY ISSUE	HC	CW	-
Rev	Date	Details of issue / revision	Drw	Rev	App

Issues & revisions

Design status

ENGINEERING
DEPARTMENT
DESIGN



Mining Remediation
Authority

Engineering

200 Lichfield Lane, Mansfield, Nottinghamshire,
NG18 4RG
Tel. 01623 637000

Project Title.

GOSHEN PARK, SKEWEN,
NEATH PORT TALBOT
SA10 6PT

Drawing Title.

DRAINAGE LEVEL FLOW
MONITORING
SECTIONS

Scale	AS SHOWN	Drawn	H. Coleman
		Reviewed	C. Whittaker
Size	A1	Approved	-

Drawing Status.

PRELIMINARY

Drawing No.	Revision.
I-365005-07-11	P3